Building 59, 3rd Floor Conference Rooms

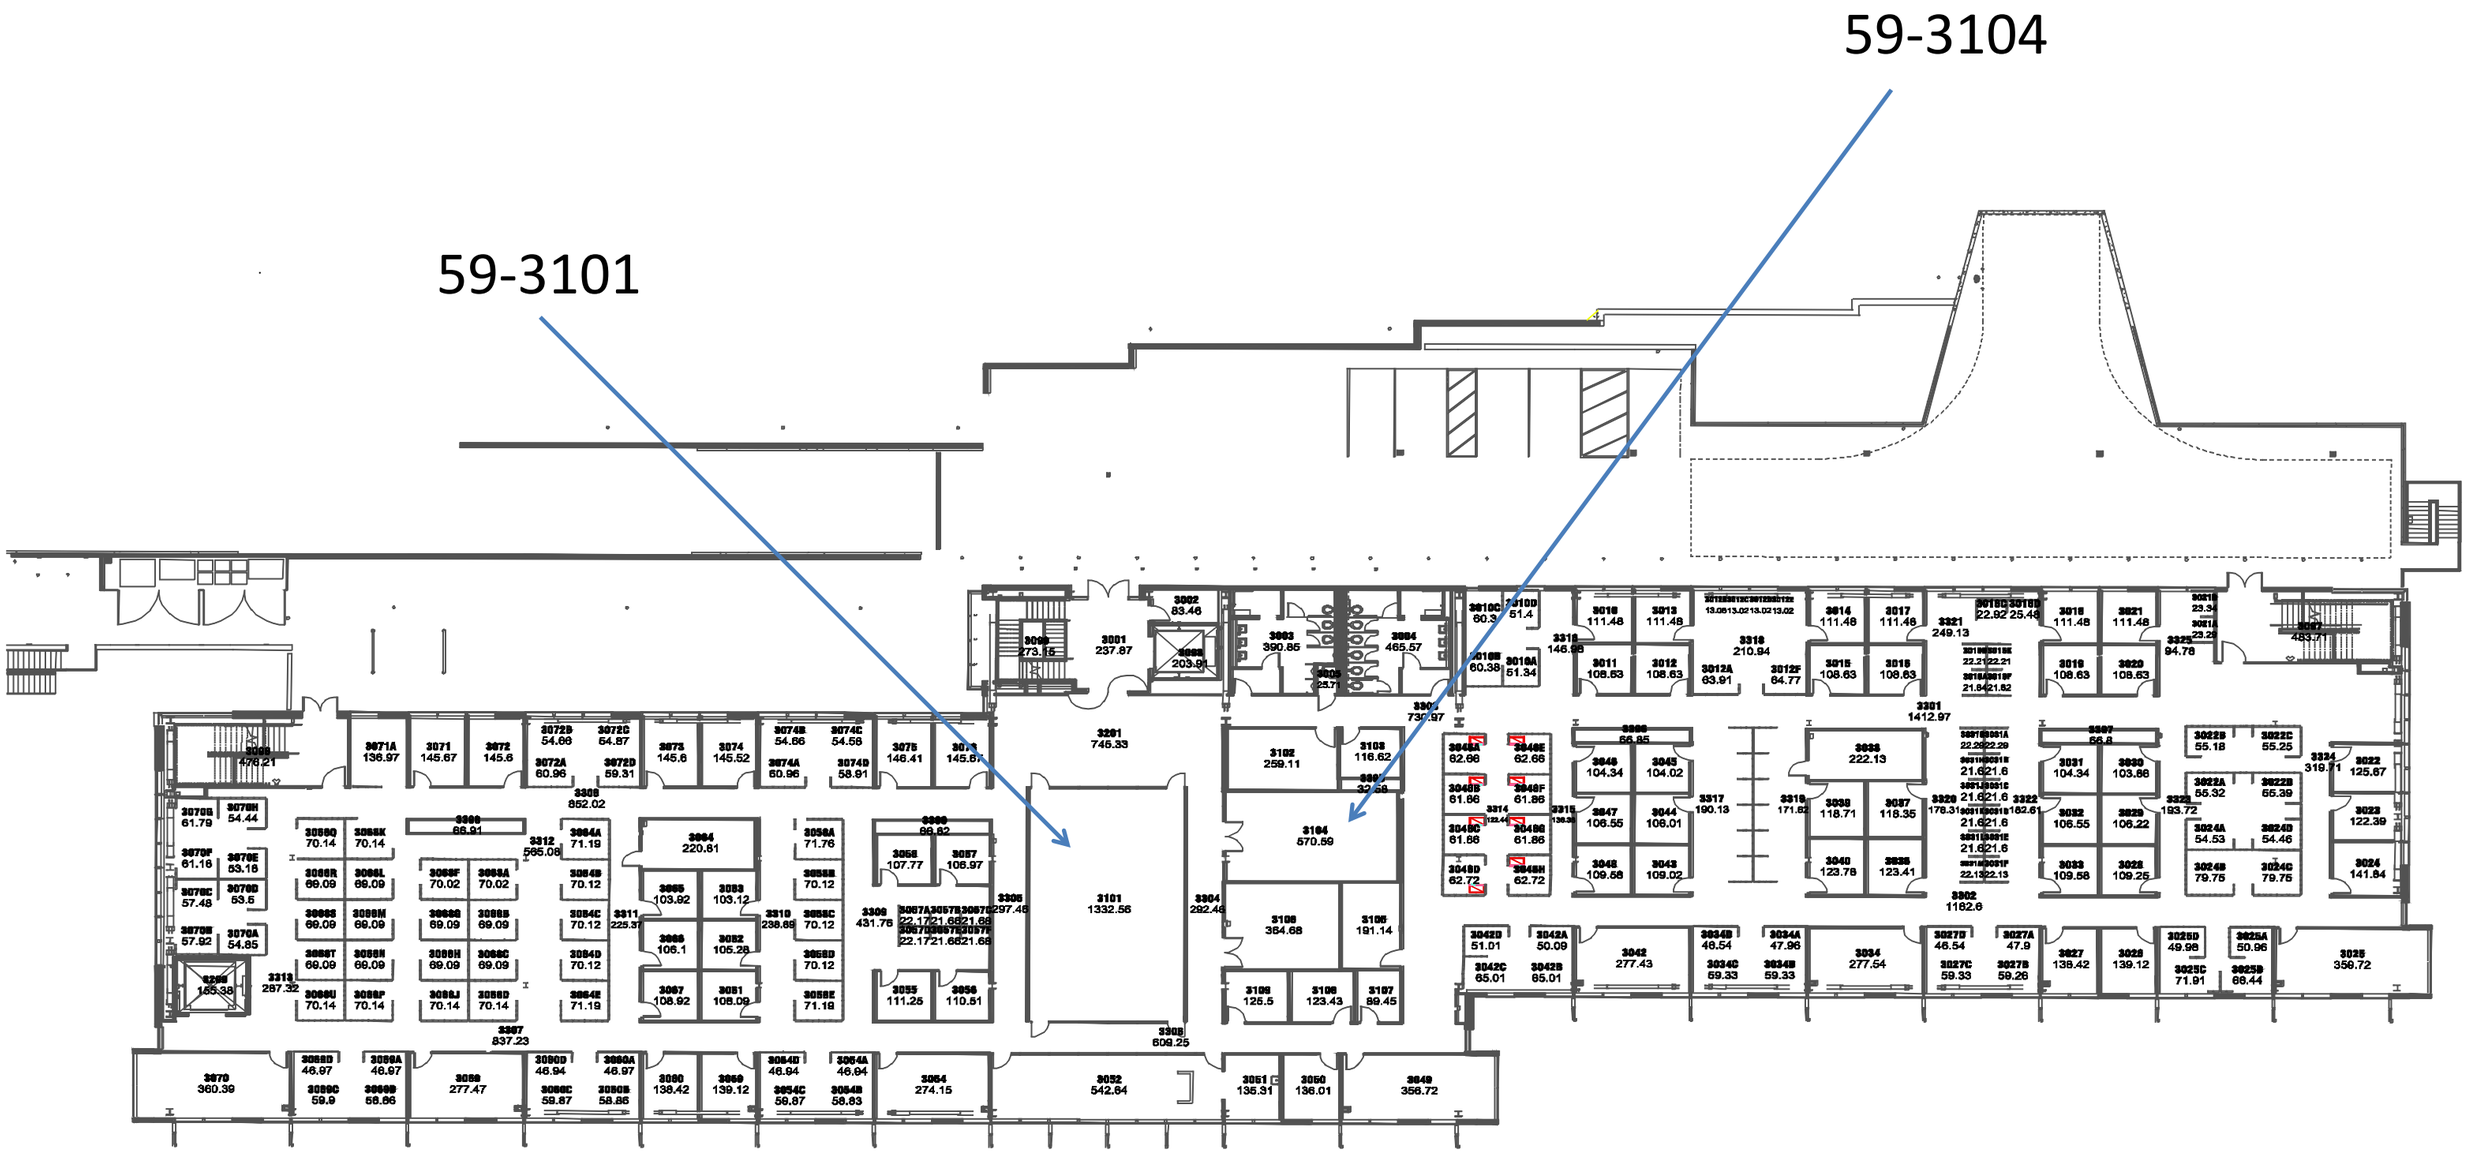

UNIVERSITY OF CALIFORNIA
LAWRENCE BERKELEY NATIONAL LABORATORY
FACILITIES DIVISION

ASBUILT CONDITION
KEYPLAN

date: 12-7-15
update: ASBUILT

59-3